CONFIDENTIAL — CUSTOMER DELIVERABLE

Executive Summary

Post-Deployment As-Built Package — azlocal-iic-01

Mode: as-built | Ranger Version: 2.1.0 | Generated: 04/06/2026 12:08:32

Table of Contents

- Document Control
- Run Summary
- Readiness Snapshot
- Environment Overview
- Topology and Operating Model
- Domain Coverage
- Operational Risk Summary
- Workload Summary
- Capacity Summary
- Acceptance and Sign-Off

Priority Recommendations

- **[WARNING]** One or more node certificates expire within 90 days
  Review certificate ownership and renew expiring node certificates before handoff.
- **[WARNING]** iDRAC firmware below recommended baseline on all nodes
  Update iDRAC firmware via Dell OME or Lifecycle Controller during next maintenance window.

Collector Overview

hardware

Status: success

Targets:

management-performance

Status: success

Targets:

monitoring-observability

Status: success

Targets:

storage-networking

Status: success

Targets:

topology-cluster

Status: success

Targets:

waf-assessment

Status: success

Targets:

workload-identity-azure

Status: success

Targets:

Document Control

Document Title	Azure Local As-Built Documentation — azlocal-iic-01
Package ID	azlocal-iic-01-as-built-20260417T020632Z
Report Tier	executive
Revision	1.0 (initial handoff)
Classification	CONFIDENTIAL — CUSTOMER DELIVERABLE
Prepared By Azure Local Ranger v2.1.0	
Prepared On	04/06/2026 12:08:32
Schema Version	1.2.0-draft
Document Status	FINAL — AS-BUILT HANDOFF

Run Summary

- Mode: as-built
- Generated: 04/06/2026 12:08:32
- Cluster: azlocal-iic-01
- Nodes: 3
- Collectors: 7/7 successful
- Artifacts currently recorded: 0

Readiness Snapshot

- Schema validation: passed
- Critical findings: 0
- Warning findings: 2
- Informational findings: 2
- Successful collectors: 7 of 7
- Partial or failed collectors: 0

Environment Overview

- VMs discovered: 5
- Azure resources discovered: 10
- Connected Azure auth method: service-principal
- Monitoring resources: 5
- Management services running: 4

Topology and Operating Model

- Deployment type: hyperconverged
- Identity mode: ad
- Connectivity mode: connected
- Storage architecture: storage-spaces-direct
- Network architecture: switched
- Variant markers: connected

Domain Coverage

- Cluster nodes: 3
- Cluster roles: 5
- Storage pools: 1
- Physical disks: 24
- Network adapters: 12
- VMs discovered: 5
- Azure resources: 10
- Alerting resources: 2
- Management services: 4

Operational Risk Summary

- Nodes not healthy: 0
- Unhealthy disks: 0
- High CPU nodes: 0
- Certificates expiring within 90 days: 1
- Azure Policy assignments: 2
- Schema warnings: 0
- Azure Advisor recommendations: total, 3 high-impact

Workload Summary

- Total VMs: 5
- Total nodes: 3
- AKS clusters: 1
- Arc-connected machines: 1
- Update compliance: No update resources tracked
- Licensing: IIC Platform Production
- VMs using Arc IP fallback: Not collected

Capacity Summary

- Storage total raw: 0 TiB
- Storage total usable: 0 TiB
- Storage used by workloads: 0 TiB (0% of usable)
- Storage reserve target: 0 TiB (0% of usable)
- Storage free usable: 0 TiB
- Projected safe allocatable: 0 TiB
- Thin provisioning ratio: Not computed
- vCPU:pCPU overcommit ratio: Not computed
- Memory overcommit ratio: Not computed
- Average VMs per node: N/A

Acceptance and Sign-Off

This as-built package was generated from the Ranger discovery run on the date shown in the Document Control section. Review all findings before accepting this package as the formal handoff record.

Role	Name	Date	Signature
Implementation Engineer			
Technical Reviewer			
Customer Representative			

Architecture Diagrams

Azure Arc Integration

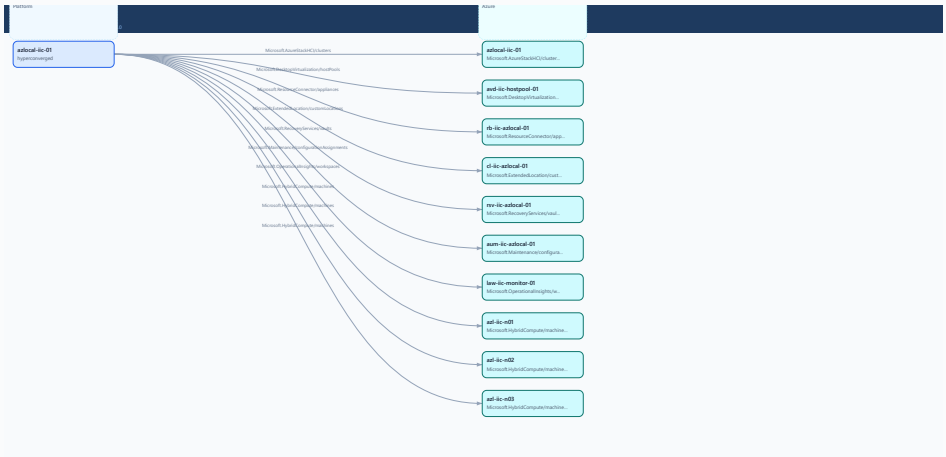

Backup Recovery Map

Disconnected Control Plane

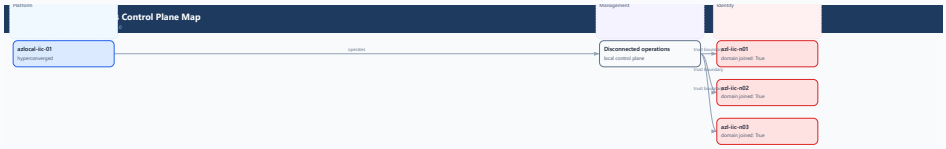

Fabric Map

Identity Access Surface

Identity Secret Flow

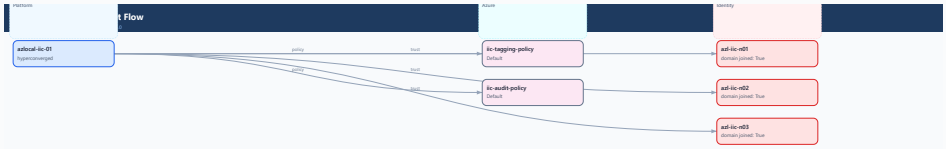

Logical Network Topology

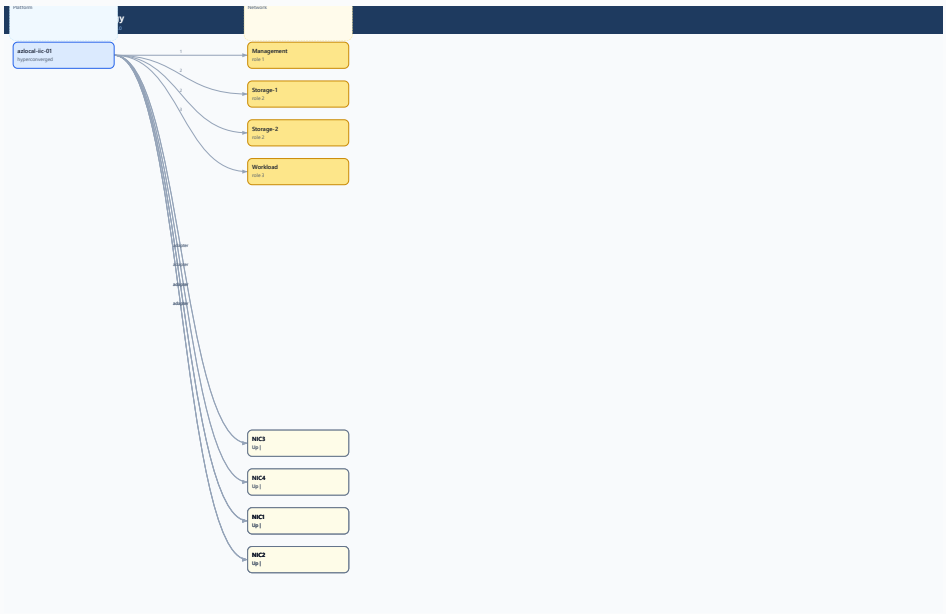

Management Plane Tooling

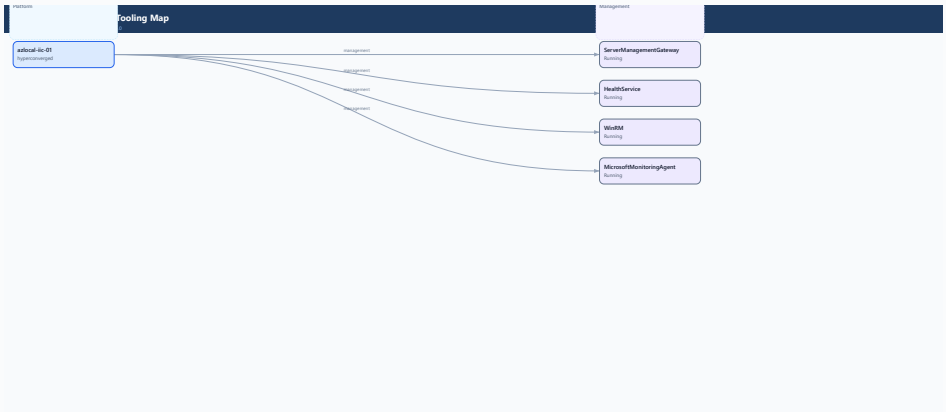

Monitoring Health Heatmap

Monitoring Telemetry Flow

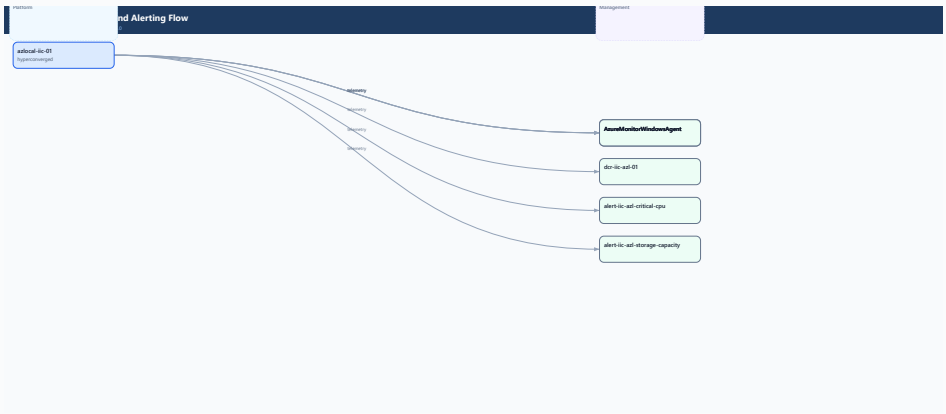

Oem Firmware Posture

Physical Architecture

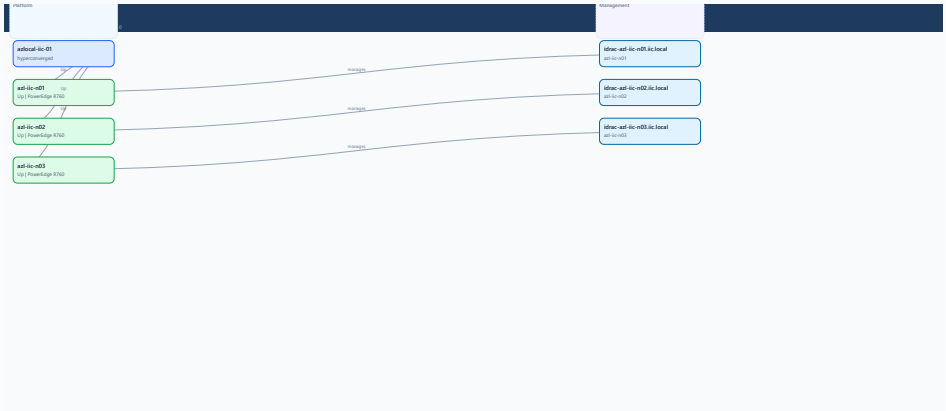

Storage Architecture

Topology Variant Map

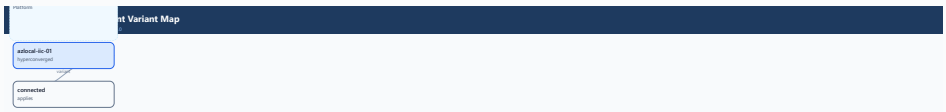

Vm Placement Map

Workload Family Placement

Workload Services Map

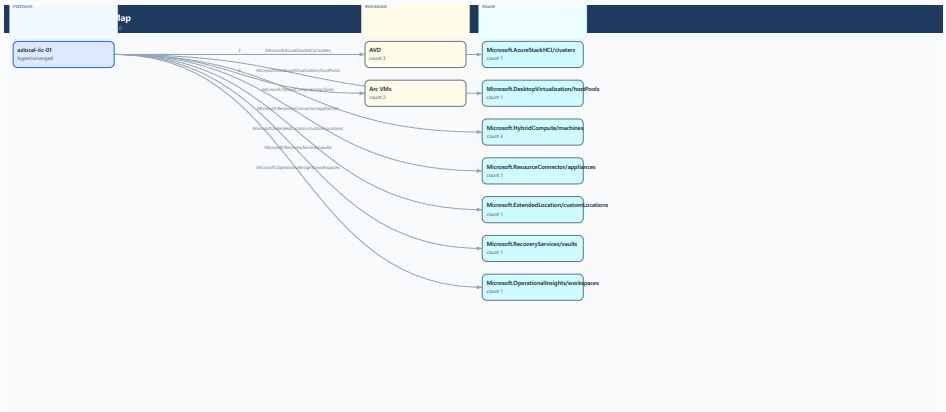

Findings

WARNING **One or more node certificates expire within 90 days**

Identity posture data indicates certificate on azl-iic-n01 expires within 90 days.

Current state: 1 certificate expiring within 90 days

Recommendation: Review certificate ownership and renew expiring node certificates before handoff.

WARNING **iDRAC firmware below recommended baseline on all nodes**

OEM integration data shows iDRAC firmware at 7.10.30.00. The recommended baseline is 7.20 or later.

Current state: iDRAC firmware 7.10.30.00

Recommendation: Update iDRAC firmware via Dell OME or Lifecycle Controller during next maintenance window.